


LEVEL 2 — REV. 15 | THE STAIR IS NOT IN THE CORRIDOR — IT IS A SEPARATE ZONE WEST OF IT

THIS RETIRES THE SIXTEEN-FOOT PROBLEM I HAVE FLAGGED SINCE REV. 6. THE CORRIDOR IS CORRIDOR FOR ALL 20 FT; THE STAIR IS ITS OWN ZONE. ALL TWENTY- EIGHT OVERLAP PAIRS ZERO.

1 — LEVEL 2 FLOOR PLAN

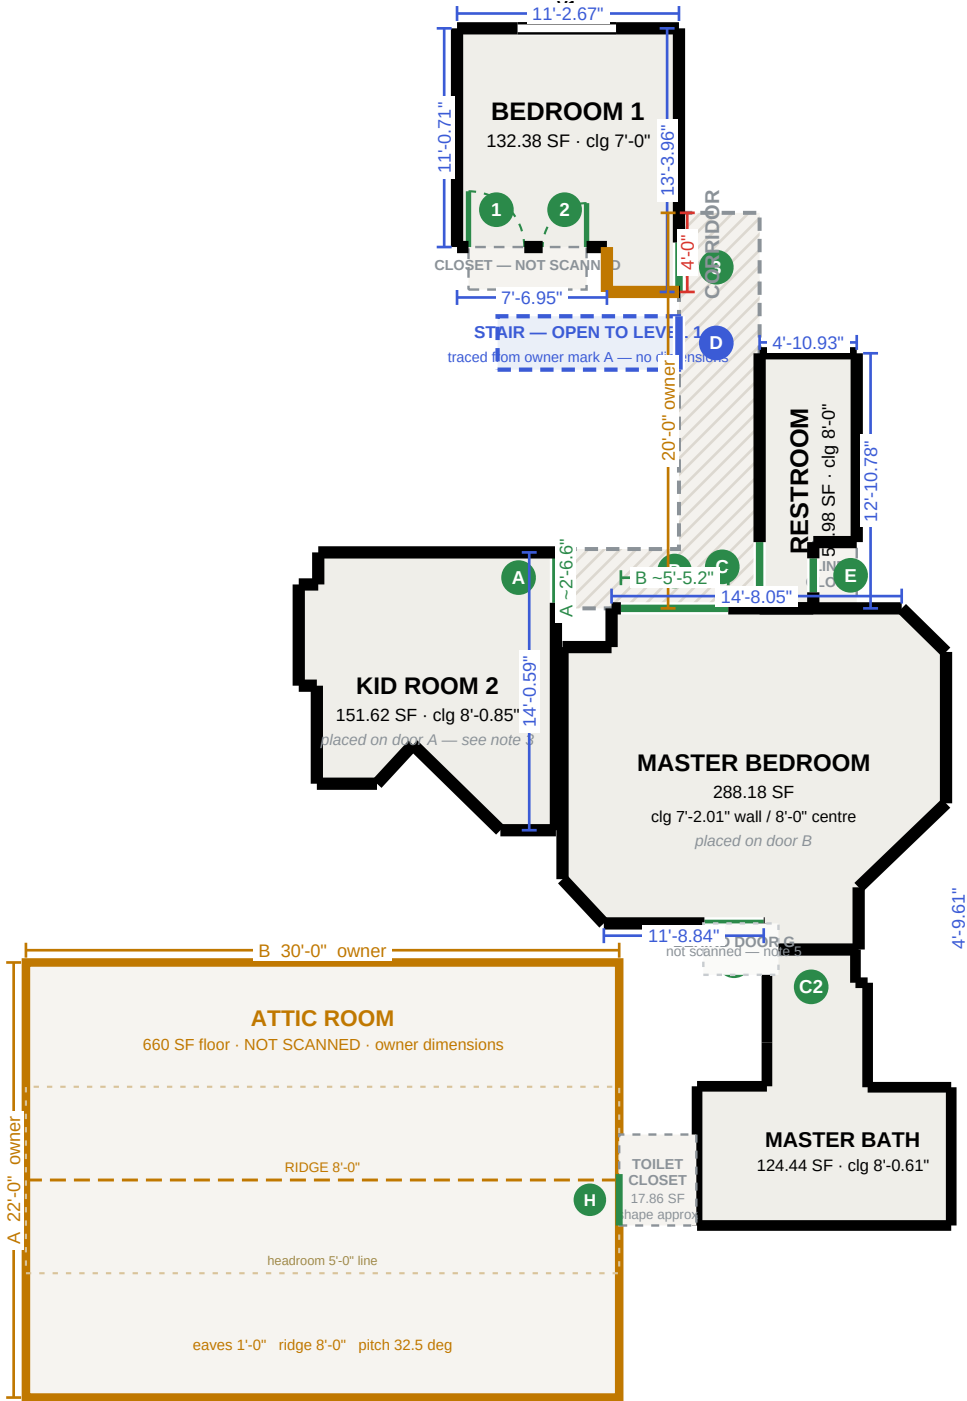

2 — VALIDATION AGAINST THE SCANS' OWN FIGURES

Three of the five scans carry an overview table. Where one exists, my polygon is checked against it. Where none exists, the area has no second source and says so.

SECTION	MY AREA	SCAN AREA	MY PERIM	SCAN PERIM	ANGLE FIX
MASTER BATH	124.45 SF	124.44 SF	53'-7.38"	53'-7.36"	0.00 deg PASS
KID ROOM 2	151.62 SF	151.63 SF	54'-4.61"	54'-4.61"	5.29 deg PASS
MASTER BEDROOM	288.18 SF	288.02 SF	68'-2.20"	68'-2.21"	1.99 deg PASS
BEDROOM 1	132.38 SF	no table	49'-1.26"	no table	0.00 deg unchecked
RESTROOM	55.98 SF	no table	35'-7.42"	no table	0.00 deg unchecked

OVERLAP TEST — ALL TWENTY-EIGHT PAIRS, 0.000000 SF

Eight placed sections, twenty-eight pairs, intersection area zero for every one. The stair zone clears bedroom 1 by 1 ft 2.7 in and kid room 2 by 9 ft 2.9 in.

ATTIC HEADROOM — WHAT 660 SF OF FLOOR ACTUALLY BUYS

Eaves 1'-0", ridge 8'-0", span 22 ft. The roof rises 7 ft over 11 ft — a 32.5 degree pitch.

MEASURE	AREA	SHARE
Floor area	660.0 SF	100%
Where headroom is at least 5'-0"	282.9 SF	43%
Where headroom is at least 6'-8" (standing)	125.7 SF	19%
Where headroom is at least 7'-0"	94.3 SF	14%

Arithmetic from your two heights, not a measurement. The 3 ft line is dashed on the plan.

3 — ROOM DATA

SECTION	AREA	CEILING	CHECKED AGAINST SCAN
01 BEDROOM 1	132.38 SF	7'-0" — centre?	no overview table
02 RESTROOM	55.98 SF	8'-0" owner	no overview table
03 KID ROOM 2	151.62 SF	8'-0.85" scan	PASSED — 151.63 SF
04 MASTER BEDROOM	288.18 SF	7'-2" / 8'-0"	PASSED — 288.02 SF
05 MASTER BATH	124.44 SF	8'-0.61" both	PASSED — 124.44 SF
toilet closet	17.86 SF	8'-0.61" scan	scan, shape approx
06 STAIR	~24.8 SF	open to Level 1	NOT SCANNED — owner mark
07 ATTIC ROOM	660.00 SF	1'-0" to 8'-0"	NOT SCANNED — owner
08 CORRIDOR	not measured	8'-0" owner	20'-0" long, owner
SCANNED TOTAL	770.46 SF	—	5 of 8 sections

4 — OPENING & DOOR SCHEDULE

TAG	CONNECTS	WIDTH	NOTES
1 / 2	BEDROOM 1 - closet	~2'-9.8" / 2'-2.6"	scaled off scan
3	BEDROOM 1 - CORRIDOR	~2'-6"	inside the 4 ft contact
A	KID ROOM 2 - CORRIDOR	~2'-6.6"	in the 14'-0.59" wall — mated
B	CORRIDOR - MASTER BEDROOM	~5'-5.2"	in the 14'-8.05" wall — mated
C	CORRIDOR - RESTROOM	~2'-6"	in the 12'-10.78" wall
D	CORRIDOR - STAIR	unknown	stair is west of the corridor
E	RESTROOM - linen closet	20.63"	in the 3'-4.21" wall
F	KID ROOM 2 - its closet	3'-0.5"	from the scan
C2	MASTER - MASTER BATH	~4'-6"	your red C, in the 4'-9.61" wall — mated
G	MASTER - unknown space	~3'-0"	still has no destination
H	TOILET CLOSET - ATTIC ROOM	unknown	the only way in — owner
V1 / V2	BEDROOM 1 / RESTROOM window	4'-11.82" / 17.48"	from the scans
V3-V5	MASTER windows, bay	3 windows	positions not drawn

5 — CEILING SCHEDULE

A scan reports the height at the wall. In a trayed, vaulted or pitched room that is the LOW figure.

6 — NOTES

- I HAD THE STAIR IN THE WRONG PLACE, AND THAT WAS THE THING THAT NEVER ADDED UP. You marked A as the stair and B as the corridor. I had been treating the lower sixteen feet of the corridor strip AS the stair. It is not in the corridor at all — it is a separate zone WEST of it, immediately south of bedroom 1, and the corridor is corridor for all twenty feet.
- THIS RETIRES A NOTE I HAVE CARRIED SINCE REV. 6. Every revision since has said that twenty feet of corridor minus four against bedroom 1 left about sixteen feet for a stair, when a flight runs ten to thirteen. The arithmetic was never wrong — my placement was. With the stair moved out, the corridor is a plain 20 ft run and nothing is left over. That note is gone.
- THE STAIR ZONE IS TRACED FROM YOUR MARK, NOT MEASURED. Your two red lines put it at roughly 9'-2" by 2'-8", about 25 SF, drawn dashed in blue with no dimensions. One thing worth saying: 2'-8" is narrow. A flight is normally 3'-0" or wider, and 2'-8" is around the minimum clear width for the flight itself, never mind the floor opening. Either the marks are approximate or this is a genuinely tight stair. One tape measurement across it settles it.
- DOOR D MOVES WITH THE STAIR. It is now an opening in the corridor's west wall over the stair's run, so you step west off the corridor onto the flight. Before it opened onto a zone inside the corridor, which was never right.
- WHAT THIS DOES NOT FIX. The stair is still the only physical link between the two floors and it is still unmeasured — run direction, tread count, width, and the size of the opening it makes in the Level 2 floor. Until that exists the two levels cannot be aligned to each other, and the combined file says so on its face.
- NOTHING ELSE MOVED. Bedroom 1, the restroom, kid room 2, the master, the master bath and the attic are all where REV. 14 left them. Overlap test now runs twenty-eight pairs across eight placed sections and every one returns 0.000000 SF. The stair zone clears bedroom 1 by 1'-2.7" and kid room 2 by 9'-2.9".
- FIVE ROOMS ARE SCANNED AND THREE VALIDATE AGAINST THE SCAN'S OWN OVERVIEW TABLE — master bath, kid room 2 and the master bedroom, each reproducing its reported area and perimeter. Bedroom 1 and the restroom have no overview table and so no second source; their areas rest on my arithmetic alone.
- THE MASTER BATH IS THE CLEANEST ROOM ON THIS FLOOR. Eleven right-angle walls, zero angle correction, area 124.45 SF against 124.44, perimeter 53'-7.38" against 53'-7.36". Eleven of its fifteen listed walls sum to exactly the reported total perimeter, which identified the outline before a line was drawn.
- THE TWO WALLS AT DOOR C2 ARE NOT THE SAME LENGTH — master 4'-9.61", bath 4'-5.72", 3.89 in apart. Two scans measuring one partition from opposite rooms. Shorter centred on longer, neither changed, neither averaged. The toilet closet is dashed at 17.86 SF, shape approximate.
- THE ATTIC IS NOT A MEASUREMENT. 30 by 22 ft, eaves 1 ft, ridge 8 ft, entered from the toilet closet — your figures, in amber, excluded from the scanned total. 660 SF of floor is not 660 SF of room: at a 32.5 degree pitch you can stand up in a band 4'-2" wide, 126 SF, 19 per cent. Which way the ridge runs is an assumption.
- BEDROOM 1 IS THE ONLY OPEN CEILING. 7'-0" at the wall, centre never measured, same sloped soffit in the photos as the master's tray. Your master bath figure of 8 ft against the scan's 8'-0.61" is still the only direct evidence the typed ceilings are sound.
- DOOR G STILL HAS NO DESTINATION. The master scan counts two doors, B and G; C2 is a third opening in a different wall, so G is not the bath. Photo 8 looks from the bath at the master's dresser through a doorway.
- The corridor still has one owner-stated length and a guessed width, and every section except bedroom 1 is positioned by a chain of mated doors that starts there.
- REV. 1 through 14 are superseded. Level 1 sheets A-10 and A-10M are unaffected.

7 — NEXT

- STAIR — width across the flight, run direction, tread count, and the opening in the Level 2 floor. This is now the only thing between two correct floors and one correct house.
- CORRIDOR — one width measurement across it.
- BEDROOM 1 — is its ceiling a tray? One reading in the middle. DOOR G — where does it go?

LONG ROAD — RESIDENCE | LEVEL 2 OF 2

SOURCE: Doc 16, 18, 19, 20, 21 scans Aug 6 + 28 photos, owner sketch, mark-ups, ceilings, corridor and attic figures

SECTIONS: 8 SCANNED: 5 PLACED: 8 SUPERSEDES REV. 1 THROUGH 14

SHEET A-20 / LEVEL 2 — IMPERIAL REV. 15 — AUG 2026